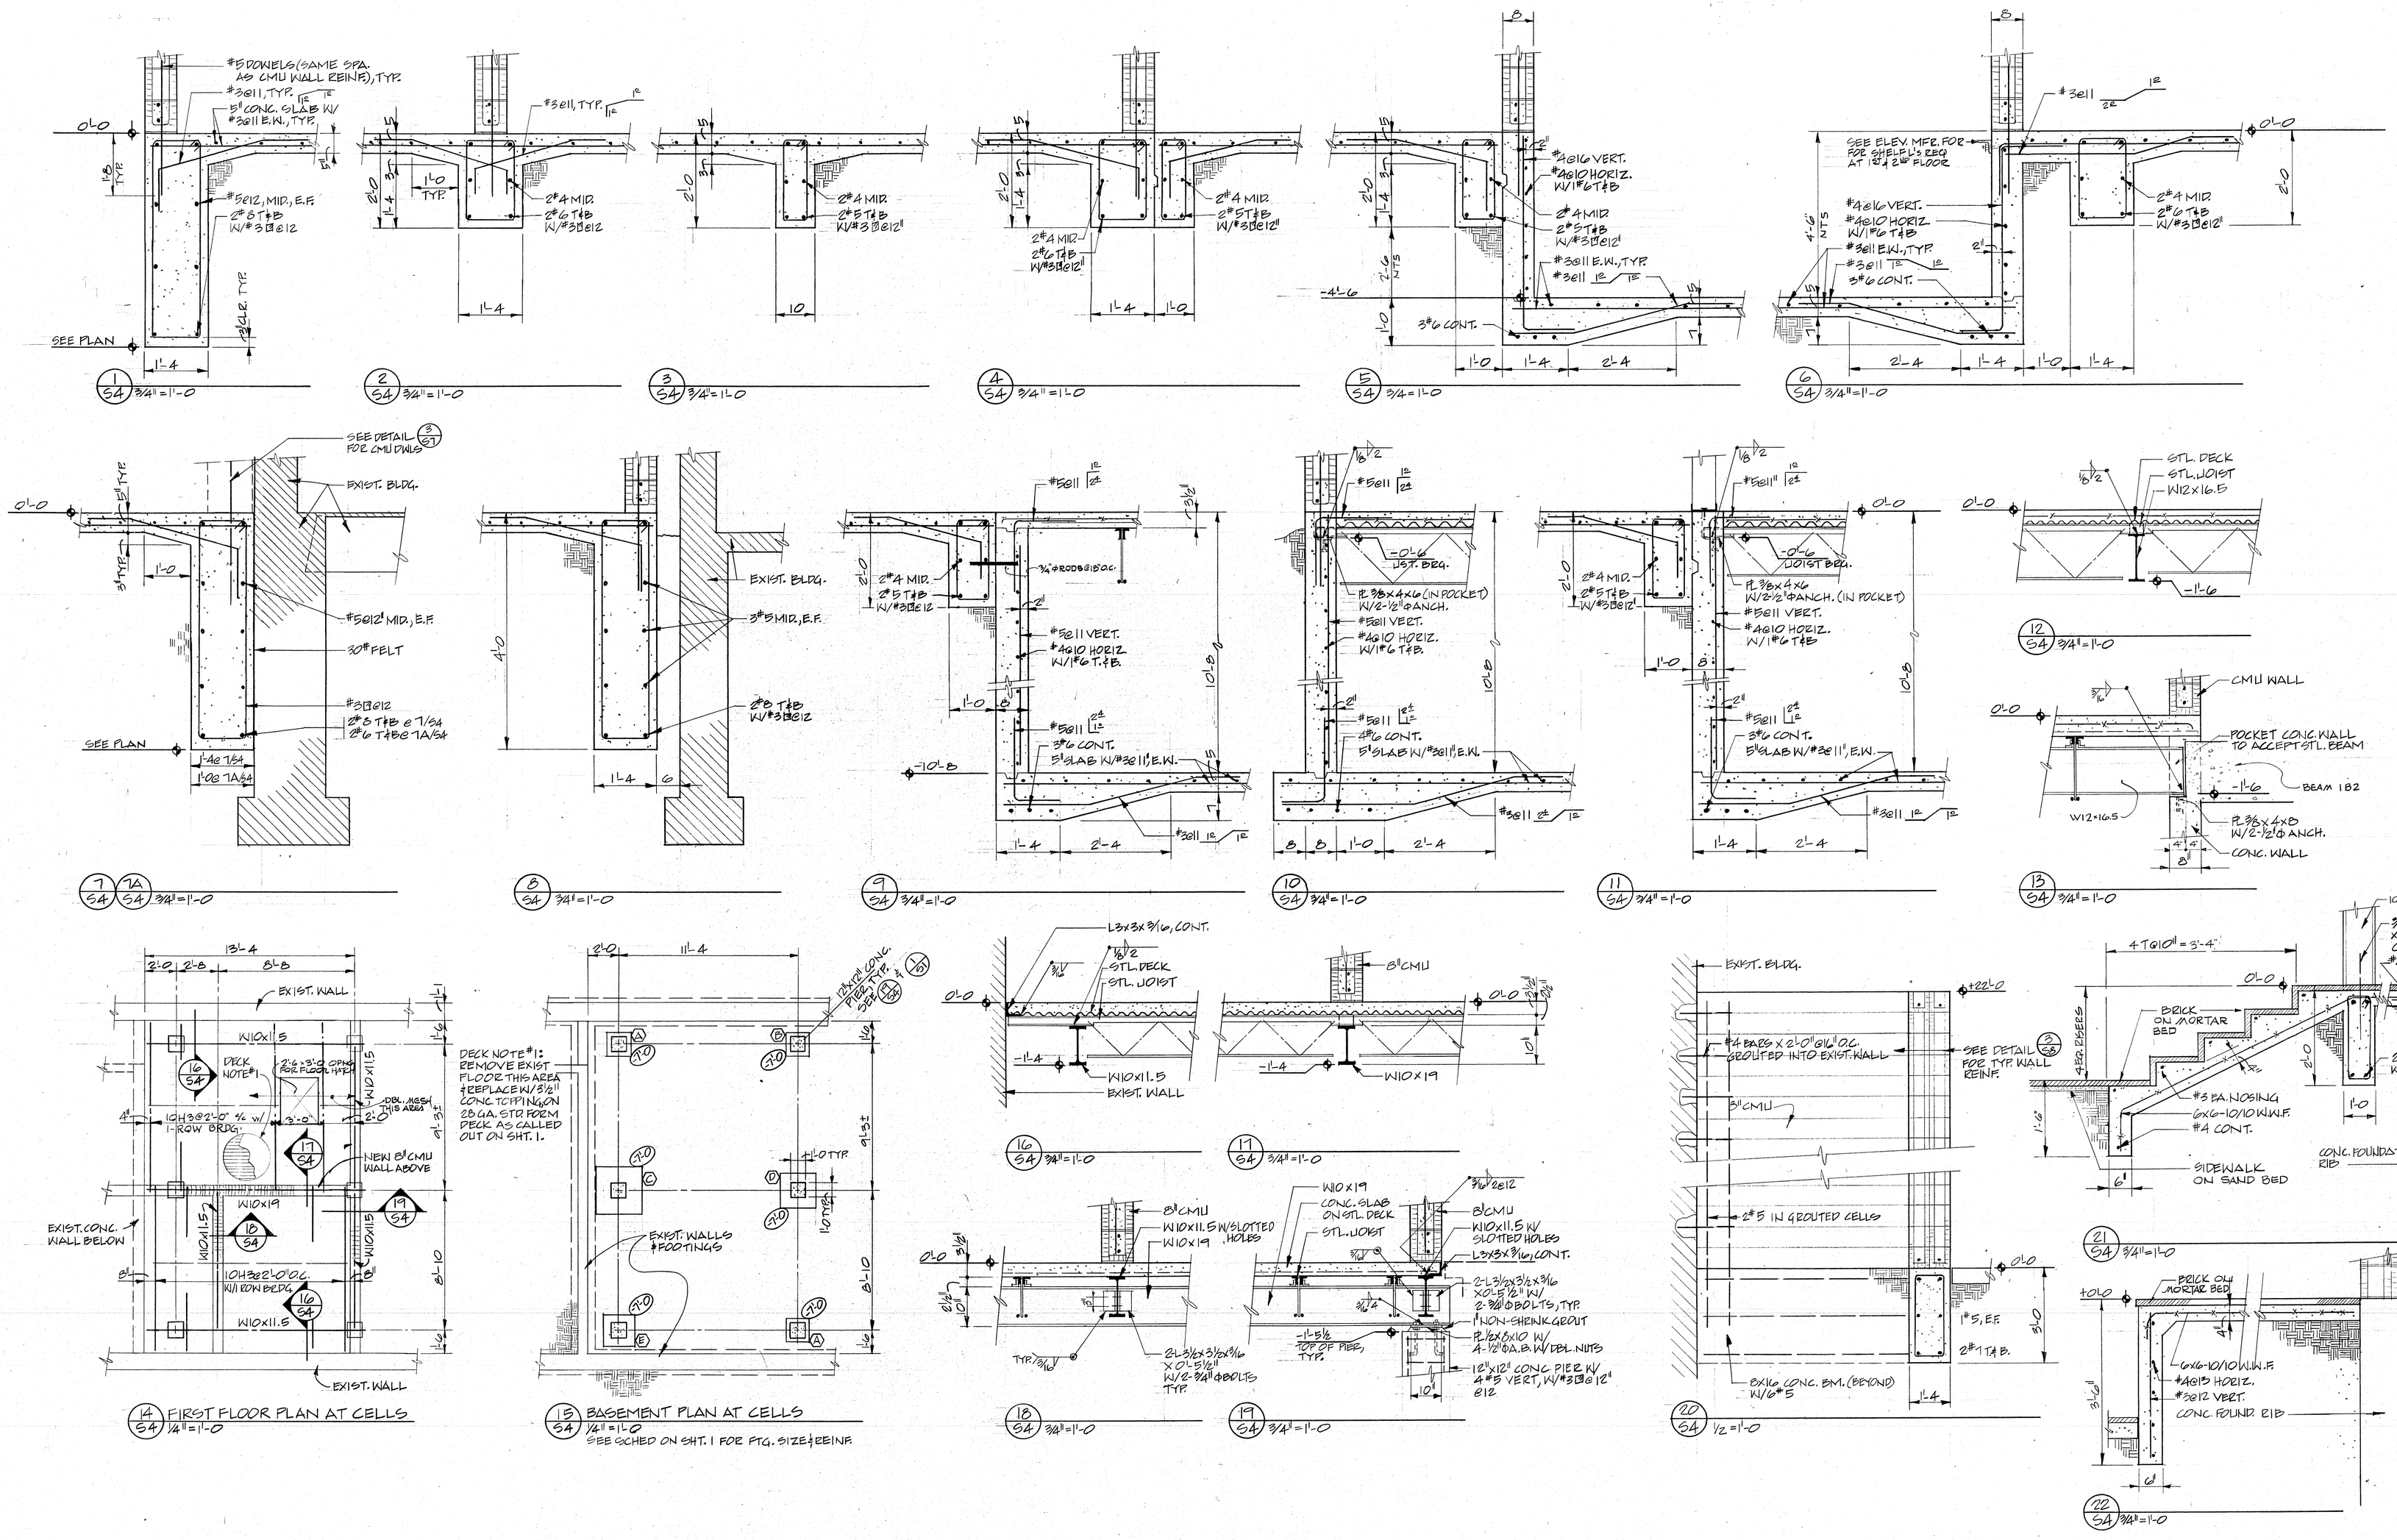

NO.	DATE	BY	APP	REVISION
1	1-2-80	JEK		AS BUILT

STATE OF NEW MEXICO — REGISTERED PROFESSIONAL ENGINEER AND LAND SURVEYOR — No. 1572 — SANTA FE, N. M. — NEW MEXICO — RESISTS & IN LAW

STATE OF NEW MEXICO — CLARK GERMANAS 53,486 — SANTA FE, N. M. — REGISTERED ARCHITECT

FOUNDATION DETAILS

COUNTY COURTHOUSE
SANTA FE COUNTY
SANTA FE, NEW MEXICO

CLARK, GERMANAS, ARCHITECTS, PC
208 DELGADO STREET SANTA FE, NEW MEXICO

DATE
DRAWN L.J.
CHECKED K.D.D.
JOB NO.

SHEET NO. S-4 OF

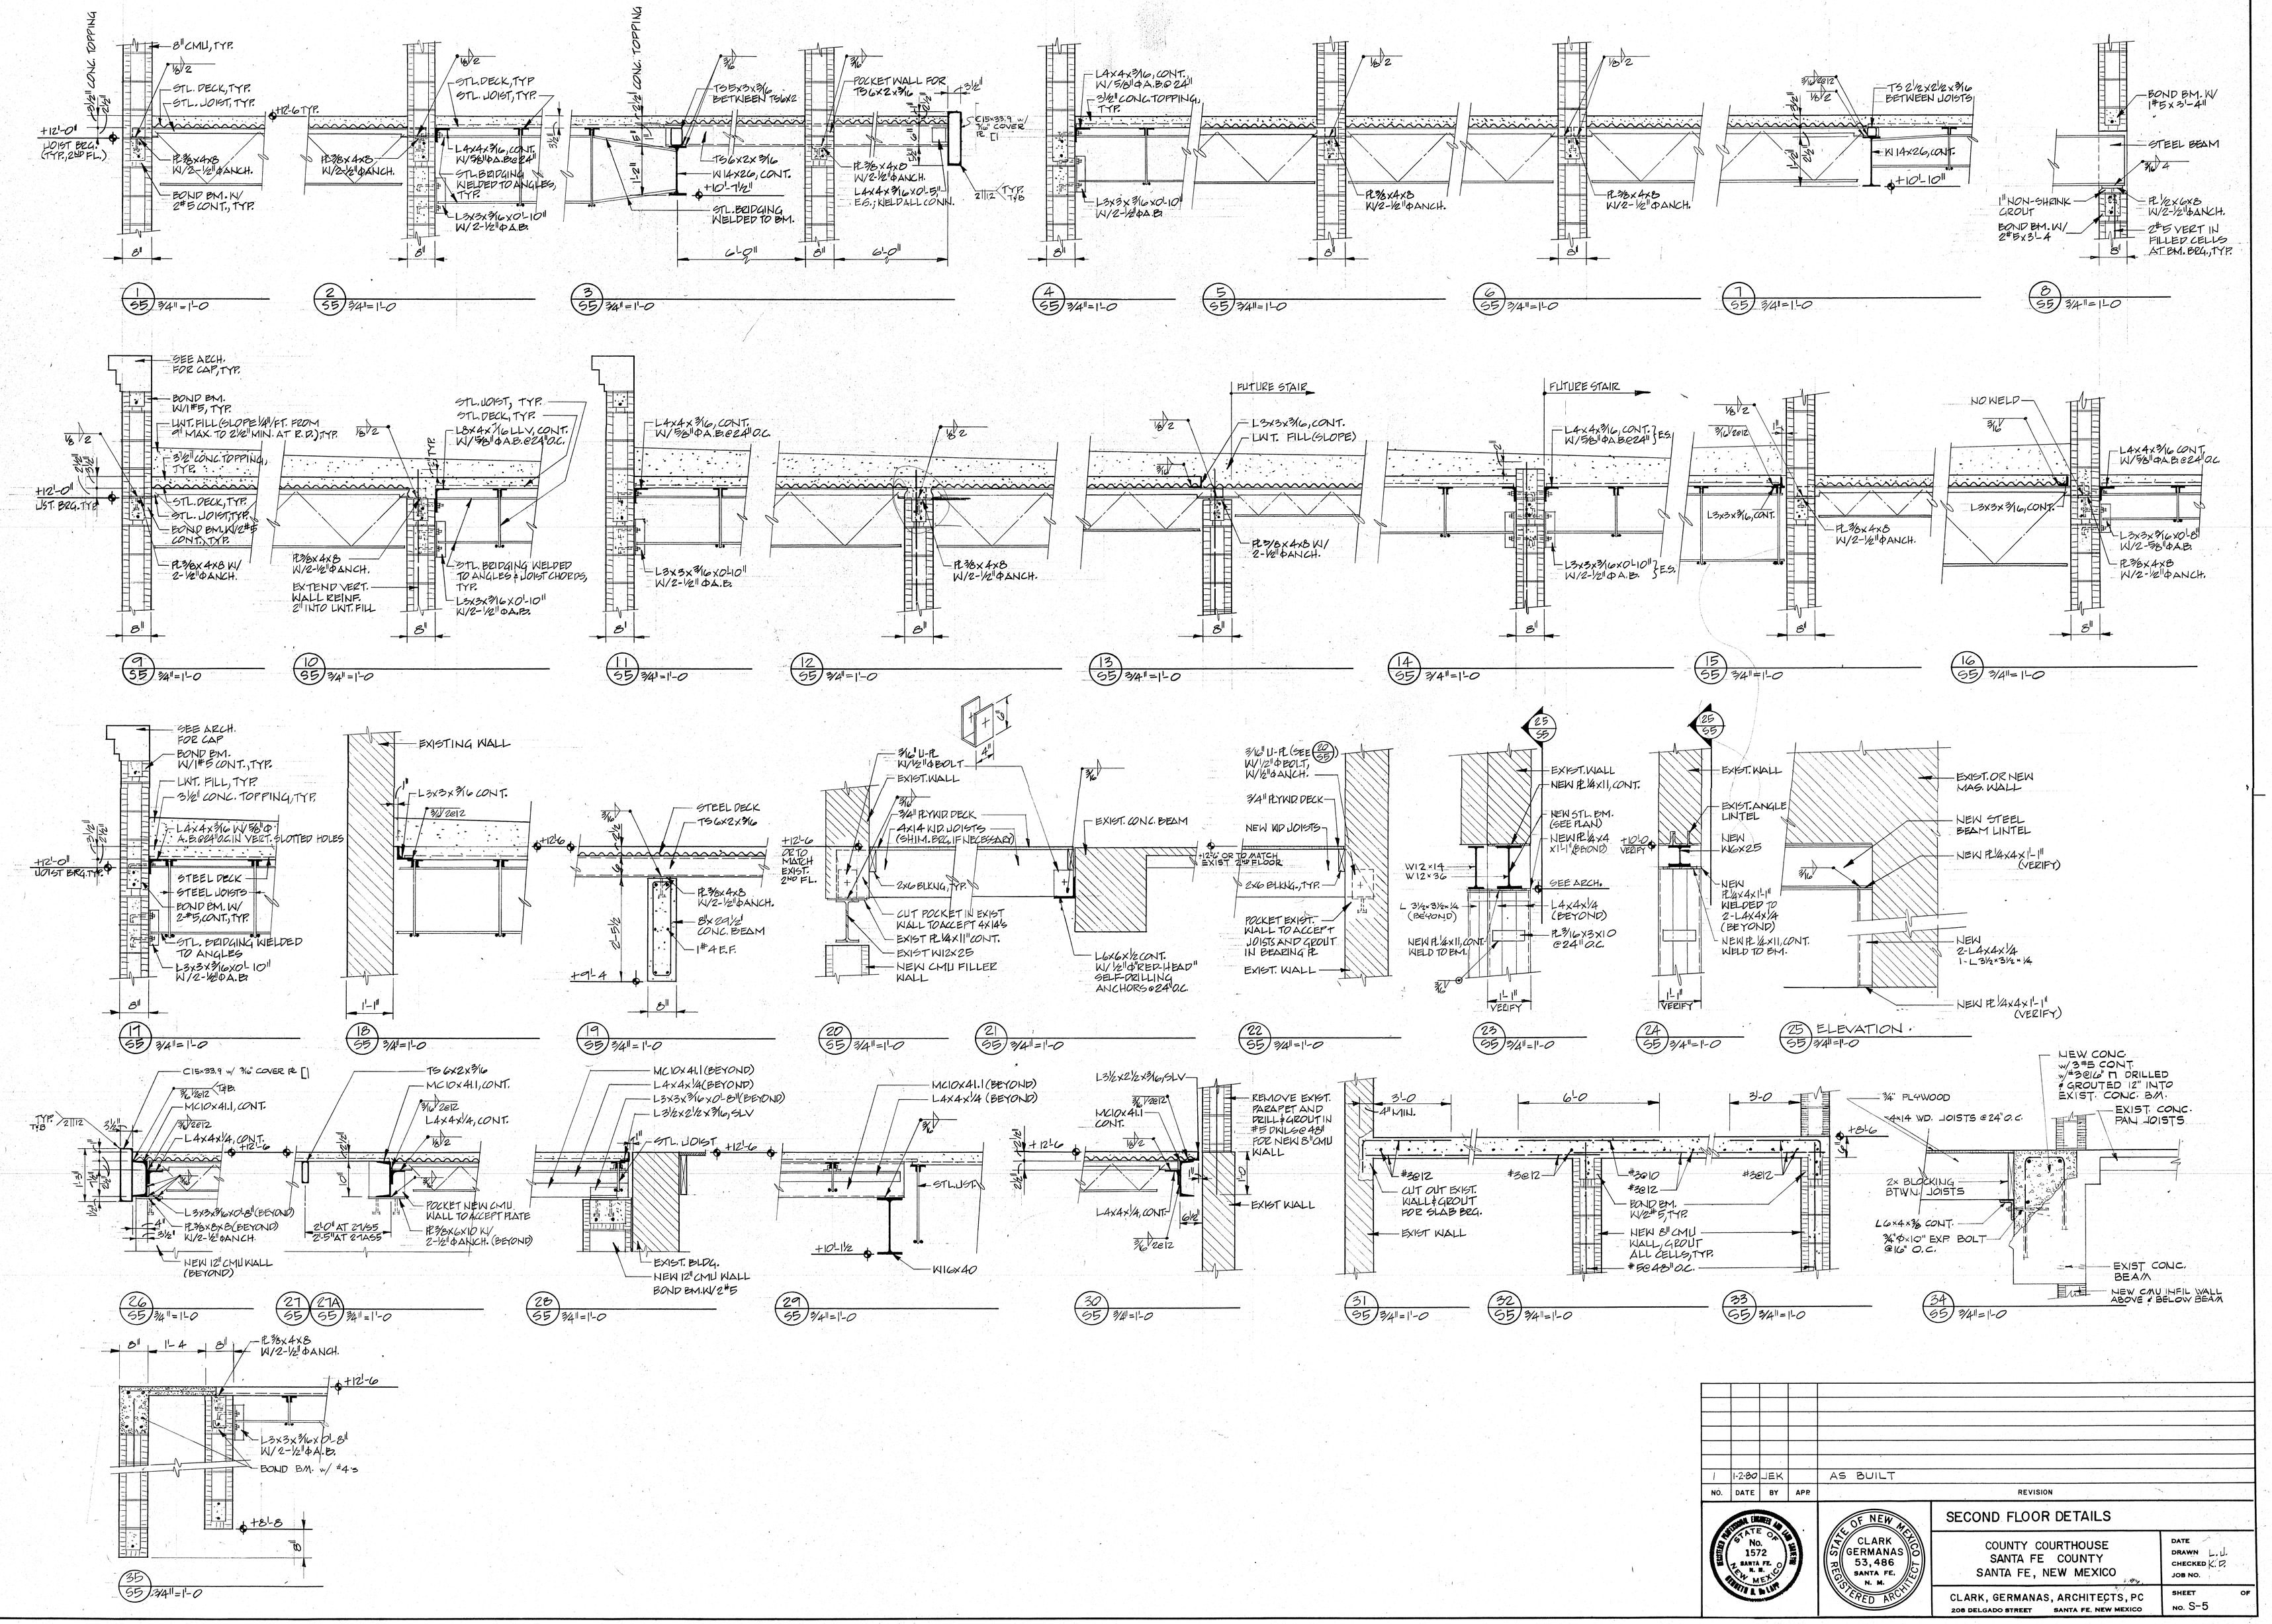

NO.	DATE	BY	APP	REVISION
1	1-2-80	JEK		AS BUILT

STATE OF NEW MEXICO — REGISTERED PROFESSIONAL ENGINEER AND LAND SURVEYOR — No. 1572 — SANTA FE, N. M. — NEWITT & McLAIN

STATE OF NEW MEXICO — CLARK GERMANAS 53,486 — SANTA FE, N. M. — REGISTERED ARCHITECT

SECOND FLOOR DETAILS

COUNTY COURTHOUSE
SANTA FE COUNTY
SANTA FE, NEW MEXICO

CLARK, GERMANAS, ARCHITECTS, PC
208 DELGADO STREET SANTA FE, NEW MEXICO

DATE
DRAWN L.J.
CHECKED K.P.
JOB NO.

SHEET OF
NO. S-5

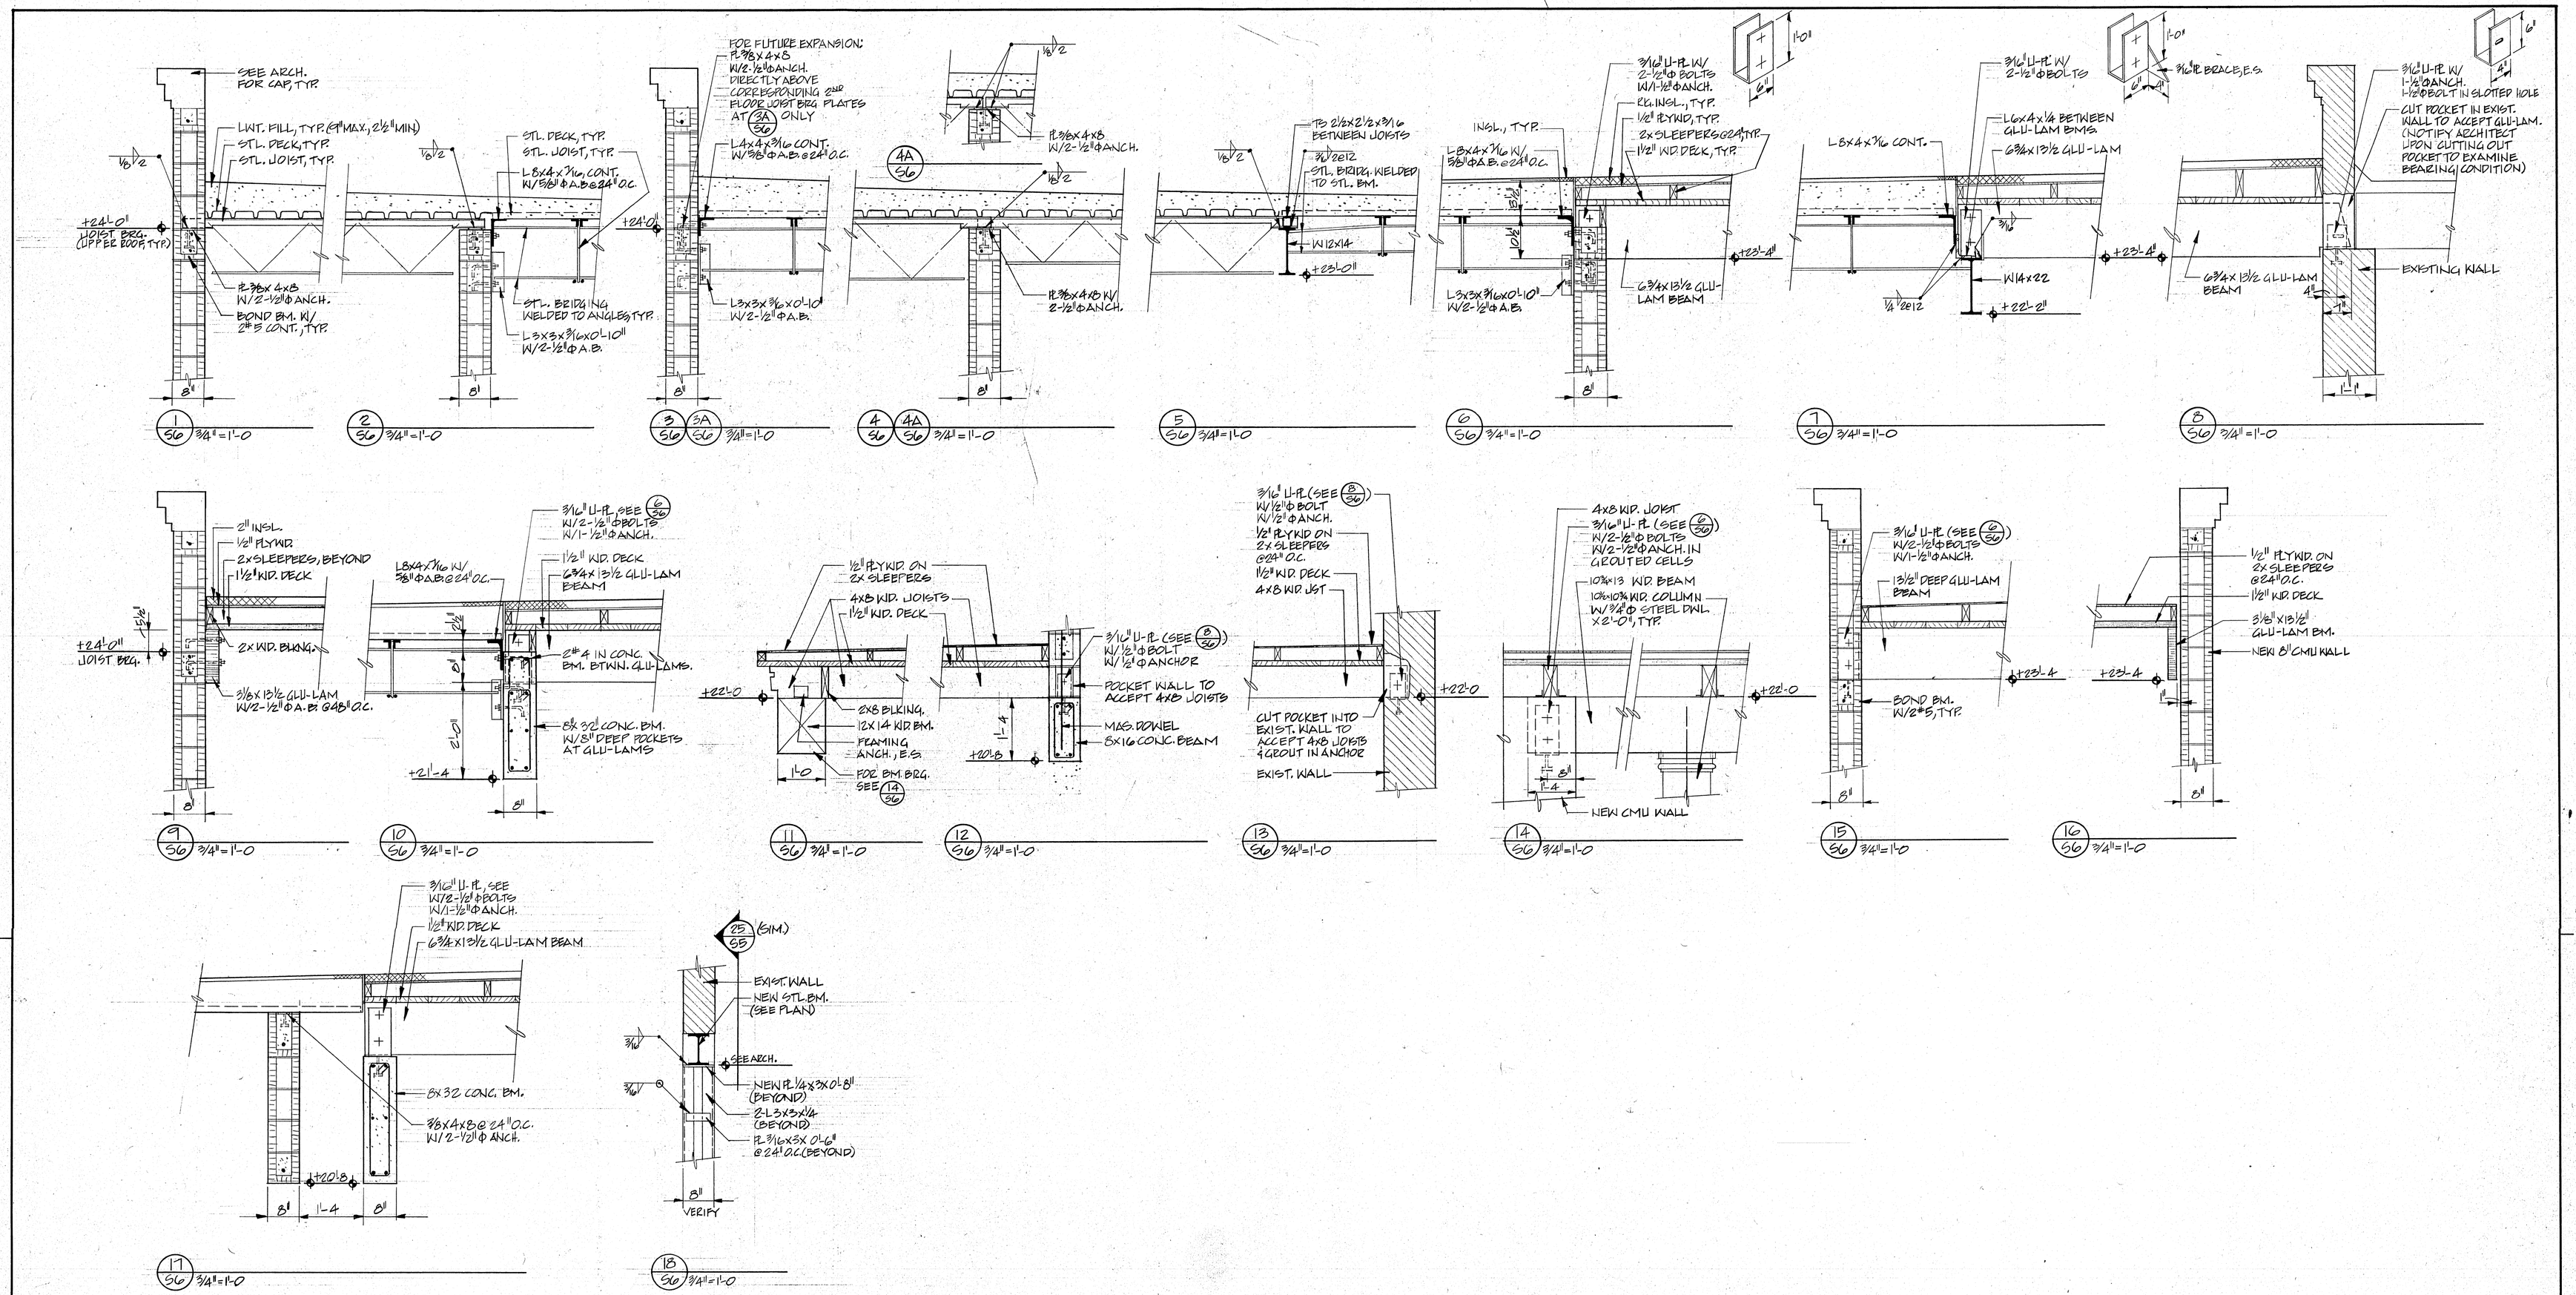

NO.	DATE	BY	APP	REVISION
1	1-2-80	JEK		AS BUILT

STATE OF NEW MEXICO — REGISTERED ARCHITECT — CLARK GERMANAS 53,486 SANTA FE, N. M.

STATE OF NEW MEXICO — No. 1572 — SANTA FE, N. M. — SMITH & BLUM

ROOF DETAILS

COUNTY COURTHOUSE
SANTA FE COUNTY
SANTA FE, NEW MEXICO

DATE
DRAWN L.J.
CHECKED K.P.
JOB NO.

CLARK, GERMANAS, ARCHITECTS, PC
208 DELGADO STREET SANTA FE, NEW MEXICO

SHEET NO. S-6 OF

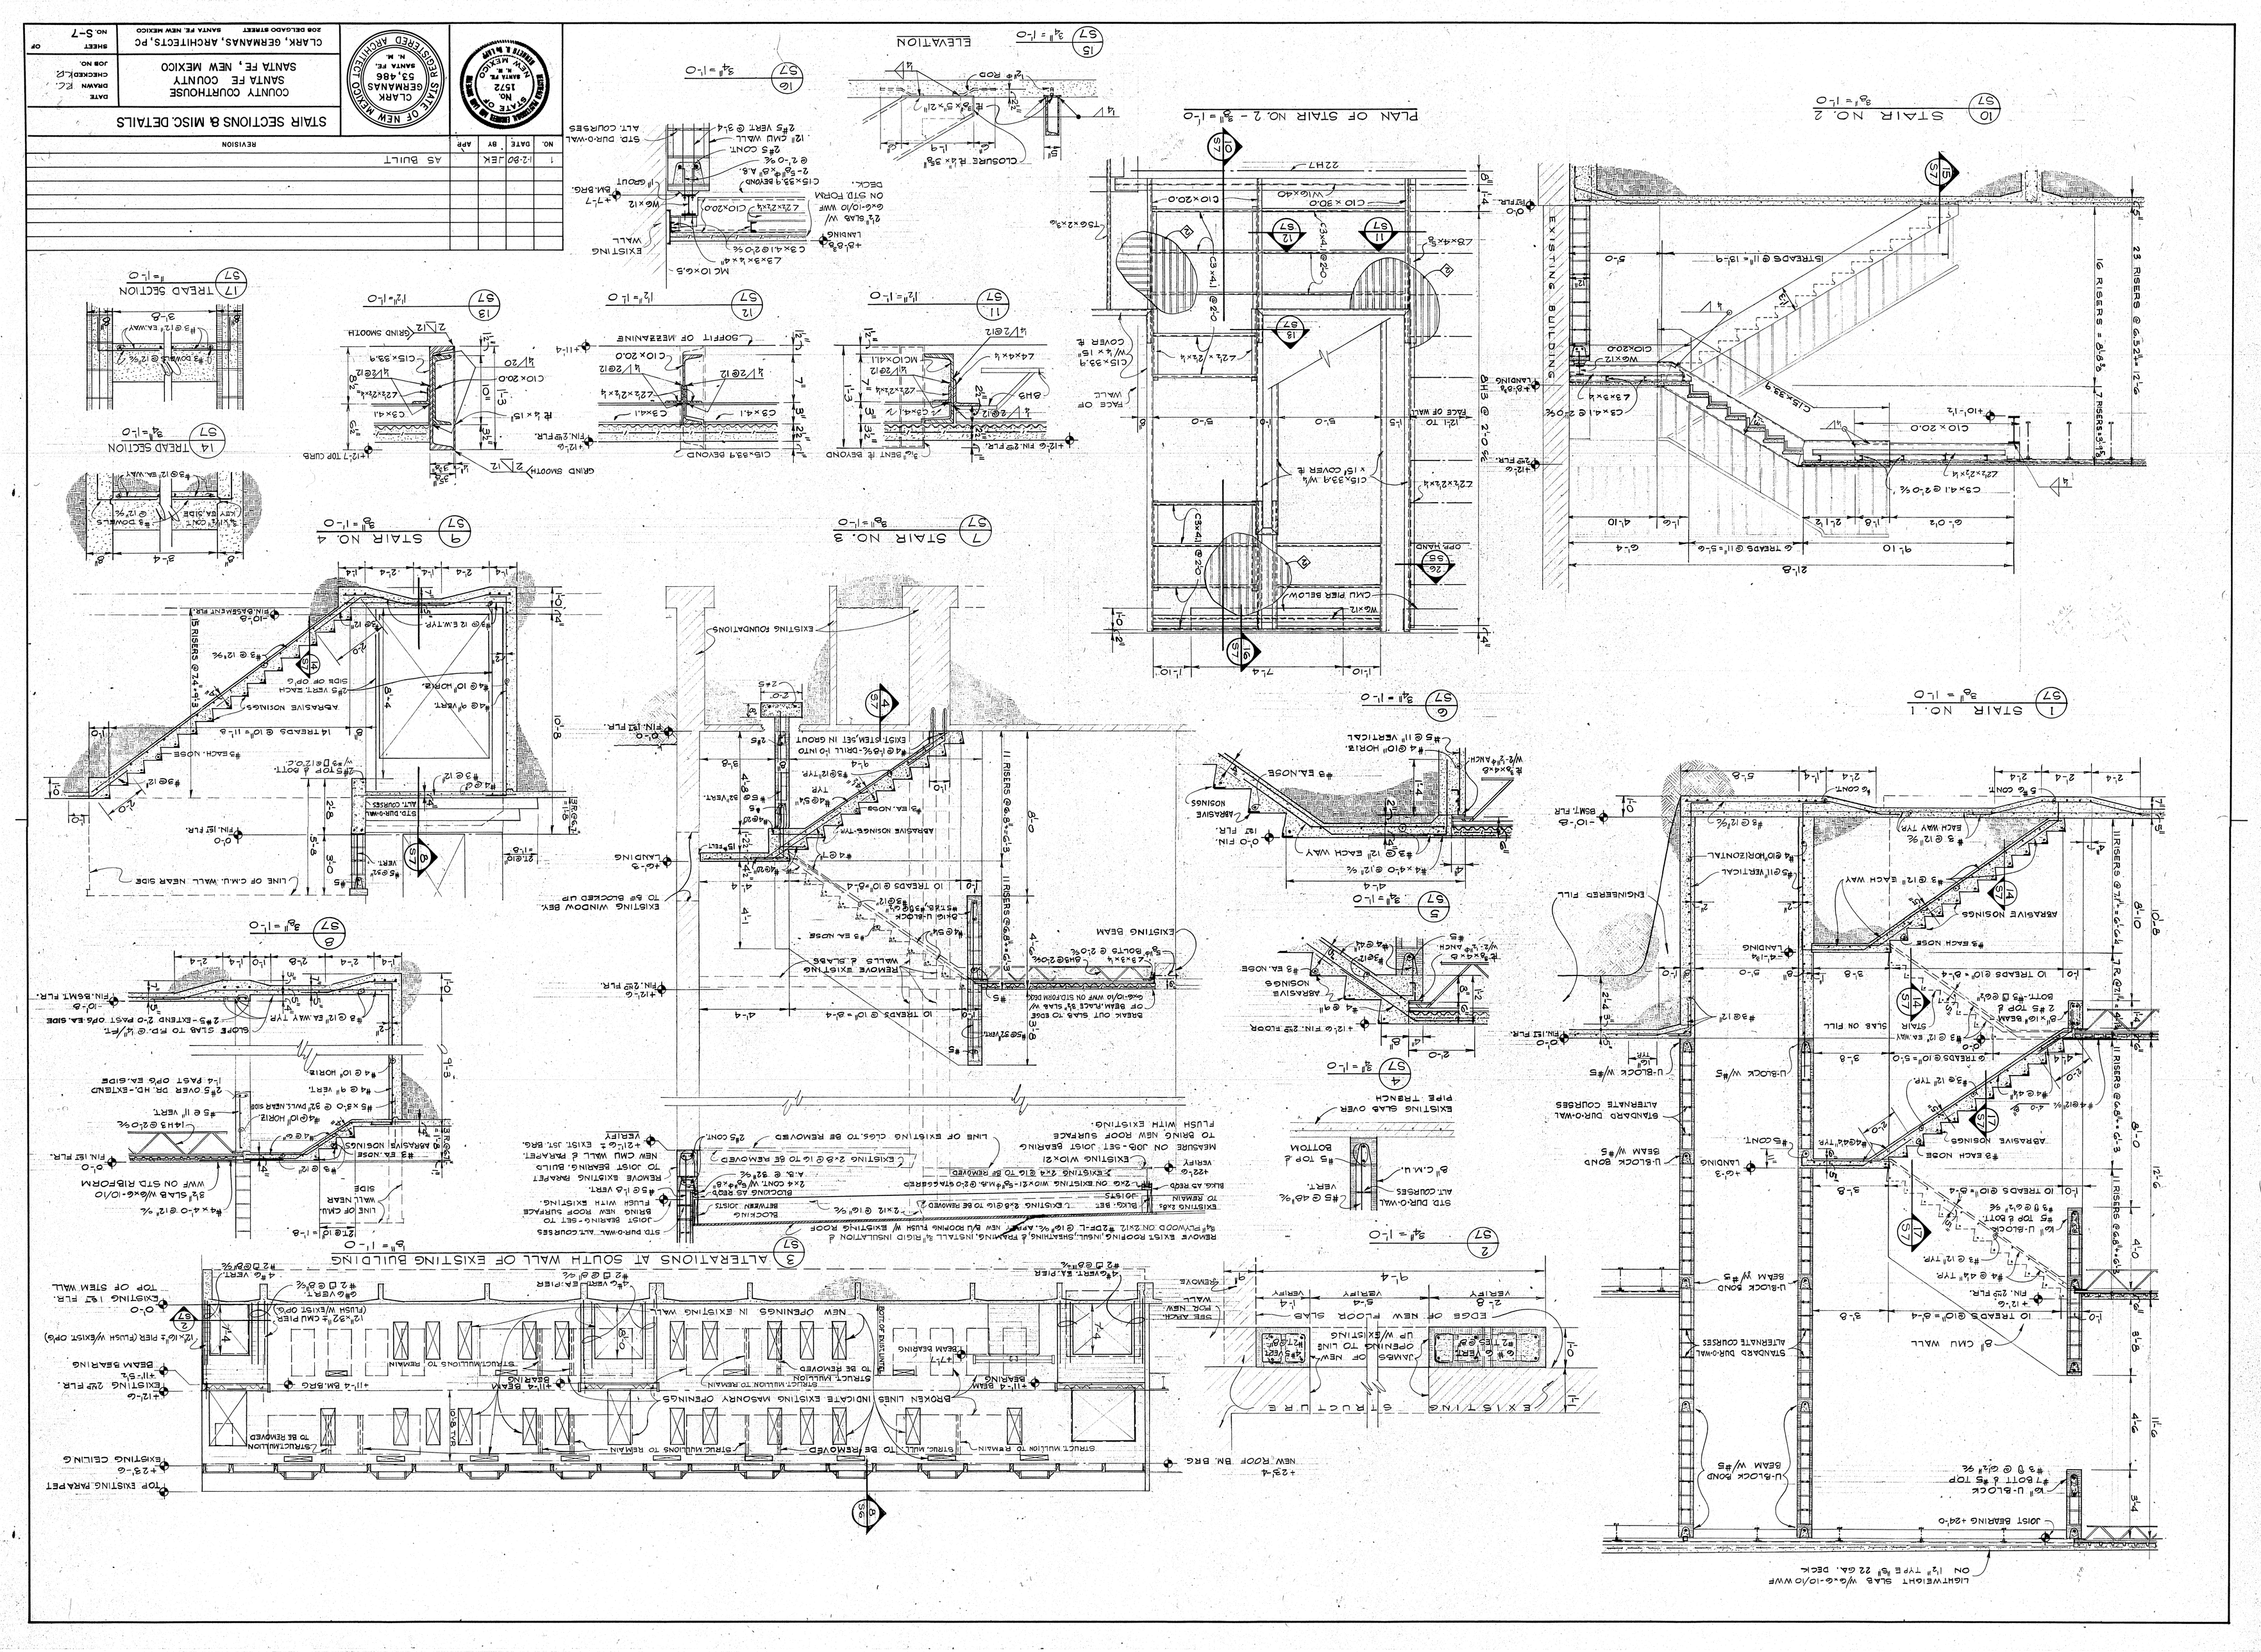
STAIR SECTIONS & MISC. DETAILS
COUNTY COURTHOUSE
SANTA FE COUNTY
SANTA FE, NEW MEXICO
CLARK, GERMANAS, ARCHITECTS, PC
208 DELGADO STREET SANTA FE, NEW MEXICO
STATE OF NEW MEXICO
CLARK GERMANAS
53,486
SANTA FE, N. M.
REGISTERED ARCHITECT
STATE OF NEW MEXICO
NO. 1372
NEW MEXICO
REVISION
NO. DATE BY APP
1 1-2-90 JEK AS BUILT
PLAN OF STAIR NO. 2 - 3/8" = 1'-0
STAIR NO. 2 3/8" = 1'-0
STAIR NO. 1 3/8" = 1'-0
STAIR NO. 3 3/8" = 1'-0
STAIR NO. 4 3/8" = 1'-0
ALTERATIONS AT SOUTH WALL OF EXISTING BUILDING 3/8" = 1'-0
ELEVATION
TREAD SECTION
EXISTING STRUCTURE
EDGE OF NEW FLOOR SLAB
NEW OPENINGS IN EXISTING WALL
EXISTING FOUNDATIONS
EXISTING BEAM
EXISTING BUILDING
23 RISERS @ 6.52" = 12'-6
16 RISERS = 8'-8 3/8"
7 RISERS = 3'-9 1/8"
11 RISERS @ 6.8" = 6'-3"
15 RISERS @ 7.4" = 9'-1 1/8"
LIGHTWEIGHT SLAB W/6x6-10/10 WWF ON 1 1/2" TYPE "B" 22 GA. DECK
SHEET NO. S-7
OF

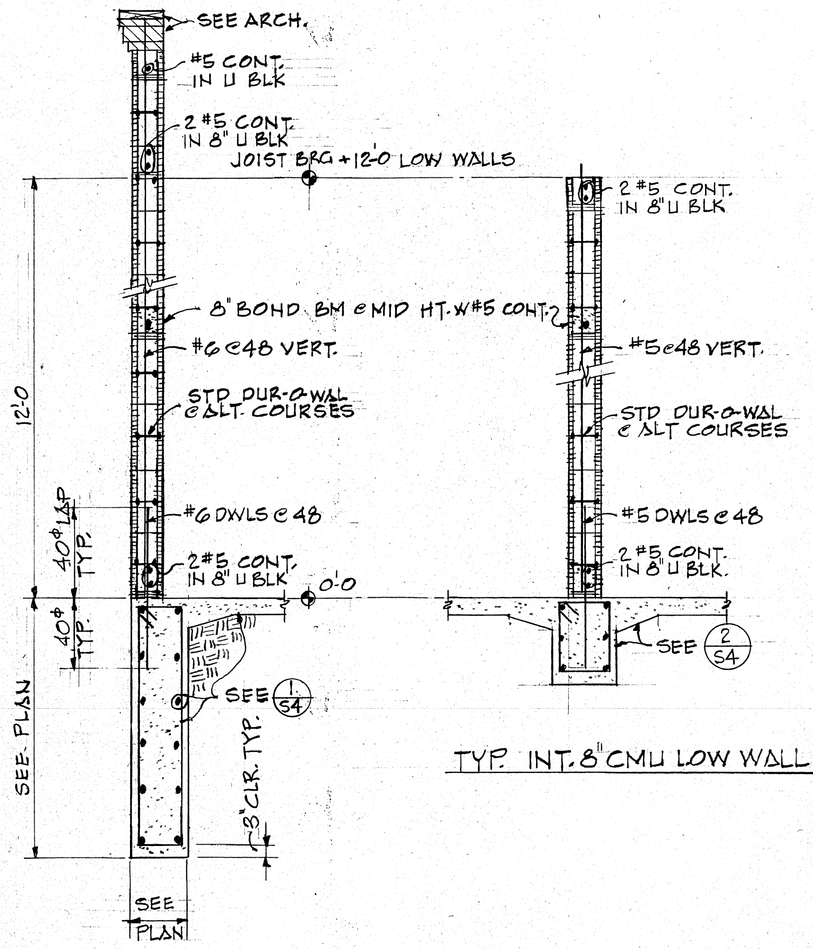

TYP. INT. 8" CMU LOW WALL (2/S8)

TYP. EXT. 8" CMU LOW WALL (1/S8)

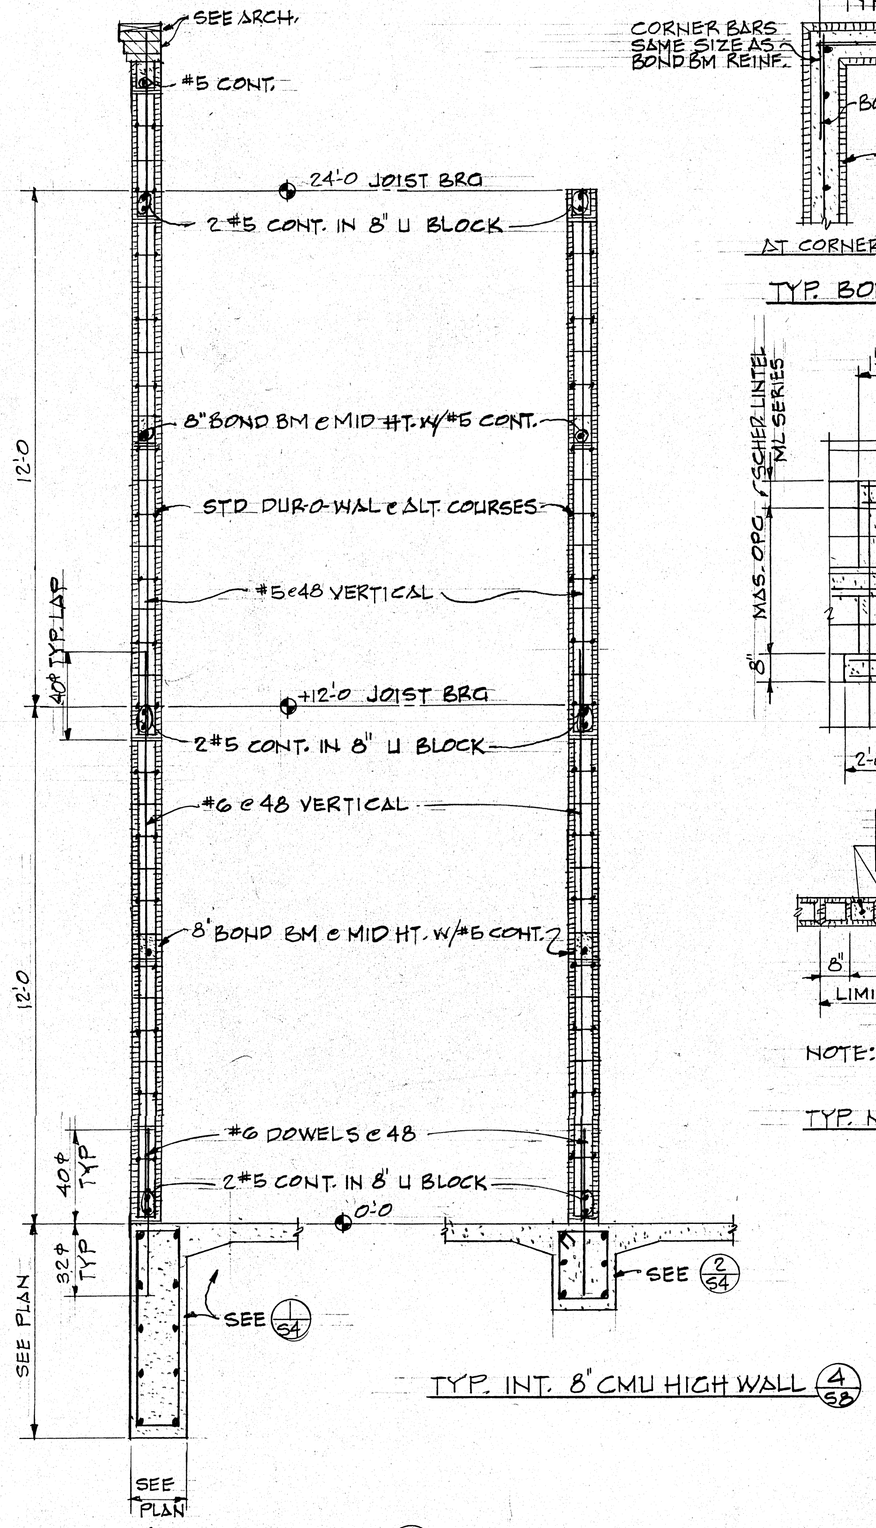

TYP. INT. 8" CMU HIGH WALL (4/S8)

TYP. EXT. 8" CMU HIGH WALL (3/S8)

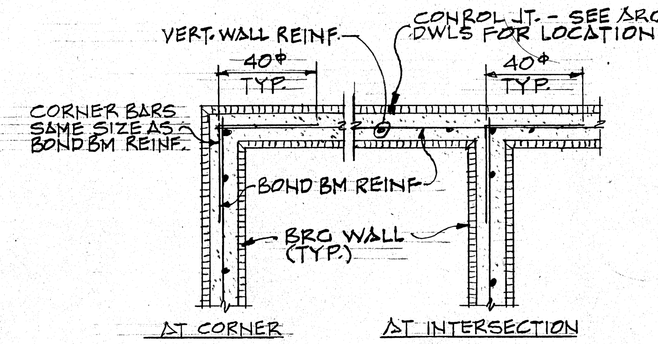

TYP. BOND BEAM PLAN DETS (5/S8)

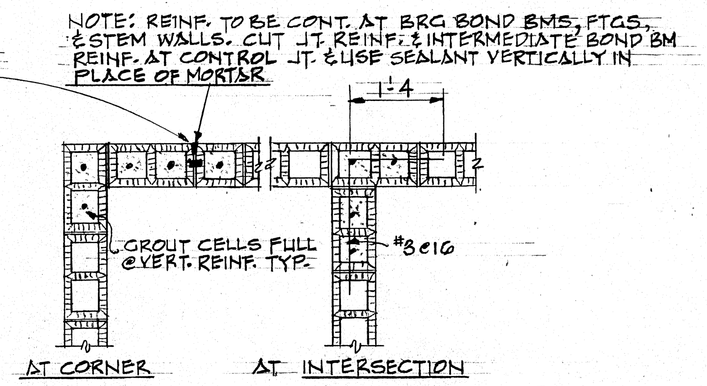

TYP. MASONRY WALL PLAN DETS (6/S8)

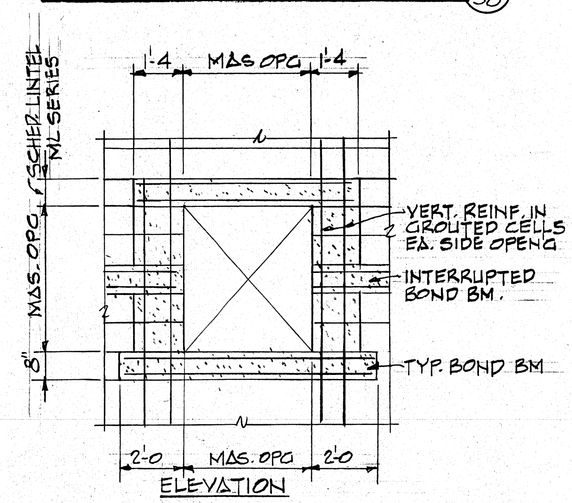

ELEVATION

VERT. REINF. EA. SIDE OF OPG. PULL HT. OF WALL WHEN OPG. EXCEEDS 4'-0 HIGH EXTEND REINF. 2'-0 PAST OPG. WHEN OPG. HT. IS LESS THAN 4'-0.

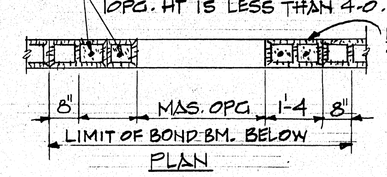

PLAN

NOTE: 2 VERT. BARS TYP. OF FREE EDGE OF WALL.

NOTE: SEE ARCH, MECH. & ELEC. DWGS FOR SIZE & LOCATION OF WALL OPGS.

TYP. MASONRY WALL OPENG (8/S8)

LINTEL & BEAM SCHEDULE						
MARK	WALL THICK	MAX. CLR SPAN	CMU OR CONC.	STEEL	TYPE	REMARKS
L1	8" CMU	4'-8	8×8 W/ 1 #5	—	A	
L2	8" CMU	8'-0	8×16 W/ 1 #5 T&B	—	B	
L3	12" CMU	8'-0	12×16 W/ 1 #5 T&B	—	B	
L4	8" CMU	6'-8	—	2 L3×3×3/8	C	
L5	12" CMU	6'-8	—	2 L5×5×5/16	C	
L6	8" CMU	5'-4	SEE REMARKS	—	D	8×16 W/ #7 BOTT., #5 TOP & #3 ⊓ @ 6"
L7	SEE REMARKS	6'-8	—	2 L3×3×3/8	E	9" THICK - VERIFY W/ EXISTING
L8	SEE REMARKS	6'-8	—	2 L5×5×5/16	E	13" THICK - VERIFY W/ EXISTING
L9	12" CMU	8'-0	12×8 W/ 1 #5	—	A	
L10	8" CMU	4'-0	SEE REMARKS	—	D	8×16 W/ #5 T&B. & #3 ⊓ @ 6"
L11	SEE REMARKS	4'-0	—	2 L3½×3½×3/8	E	VERIFY W/ EXISTING
1B1	8" CONC.	SEE (3/S4)	8×16	—	F	2 #8 BOTT., 2 #6 TOP W/ #3 ⊓ @ 10
1B2	8" CONC.	SEE REMARKS	SEE REMARKS	—	F	2 #5 OVER DOOR. SEE (1/S4)
2B1	8" CONC.	SEE PLANS	8×24	—	F	2 #8 BOTT., 2 #6 TOP W/ #3 ⊓ @ 10
2B2	8" CONC.	SEE PLANS	8×29½	—	F	2 #7 BOTT., 2 #5 TOP W/ #3 ⊓ @ 10
2B3	8" CMU	SEE PLANS	SEE REMARKS	—	A	8×8 W/ #6 BOTT., #4 TOP
2B4	8" CONC.	SEE PLANS	8×16	—	F	2 #6 BOTT., 2 #4 TOP W/ #3 ⊓ @ 6½
2B5	8" CONC.	SEE PLANS	8×16	—	F	2 #7 BOTT., 2 #5 TOP W/ #3 ⊓ @ 6½
2B6	8" CONC.	SEE PLANS	8×16	—	F	2 #8 BOTT., 2 #6 TOP W/ #3 ⊓ @ 6½
RB1	8" CONC.	SEE PLANS	8×16	—	F	2 #7 BOTT., 2 #5 TOP W/ #3 ⊓ @ 6½
RB2	8" CONC.	SEE PLANS	8×24 SEE (12/S8)	—	F	2 #6 BOTT., 2 #4 TOP W/ #3 ⊓ @ 6½
RB3	8" CONC.	SEE PLANS	8×32	—	F	2 #5 BOTT., 2 #4 TOP W/ #3 ⊓ @ 10

NOTE: PROVIDE 1'-4 MIN. BEARING EA. END WHERE POSSIBLE, ALL LINTELS & BEAMS. TYPICAL. ML SERIES SHOWN ON PLAN REFERS TO MECH OPGS. SEE SCHED. FOR SIZE & REINF. FOR VARIOUS SPANS.

NOTE: SEE SCHED. FOR ALL LINTEL & BEAM SIZES & REINF.

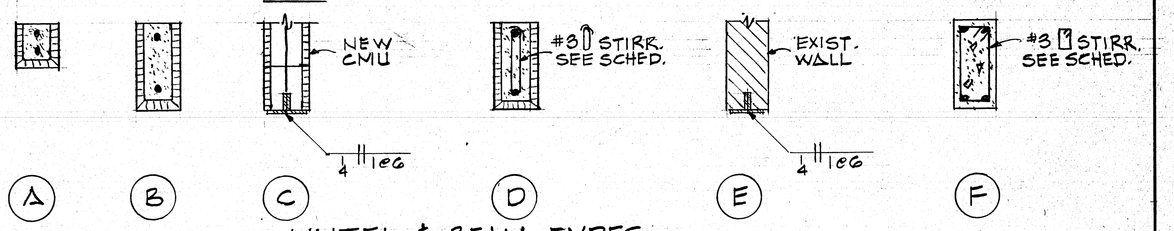

LINTEL & BEAM TYPES

N.T.S.

NO.	DATE	BY	APP	REVISION
1	1-2-80	JEK		AS BUILT

STATE OF NEW MEXICO No. 1572 SANTA FE, N. M. NEW MEXICO

STATE OF NEW MEXICO CLARK GERMANAS 53,486 SANTA FE, N. M. REGISTERED ARCHITECT

MISCELLANEOUS DETAILS-MASONRY

COUNTY COURTHOUSE
SANTA FE COUNTY
SANTA FE, NEW MEXICO

DATE
DRAWN E.C.
CHECKED K.D.
JOB NO.

CLARK, GERMANAS, ARCHITECTS, PC
208 DELGADO STREET SANTA FE, NEW MEXICO

SHEET OF
NO. S-8