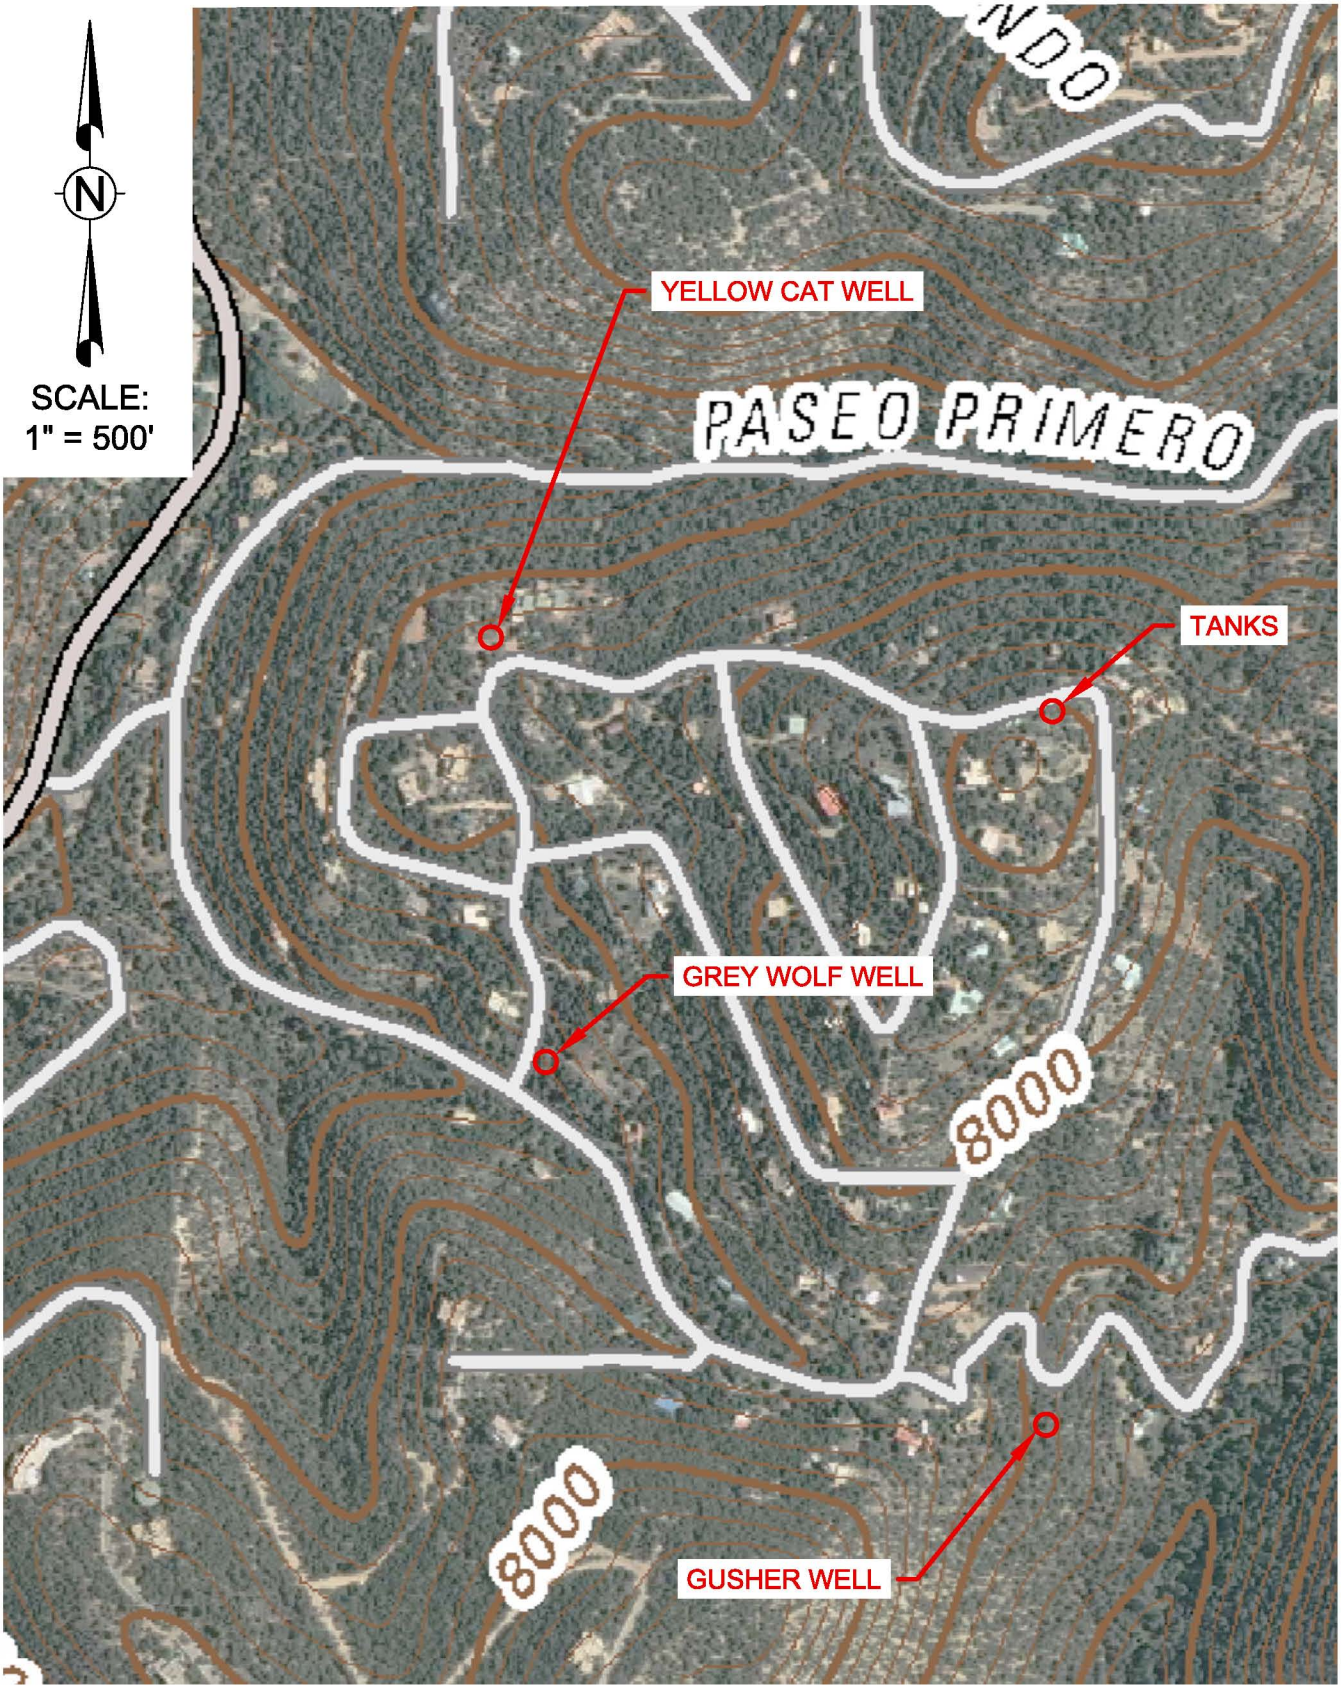

REFERENCE:
USGS Quadrangle Maps Entitled
"SANTA FE, N. MEX" Dated 2011

WELLS AND TANK
LOCATION MAP
FIGURE 2

APPENDIX B

AS BUILT DRAWINGS AND AVAILABLE REPORTS

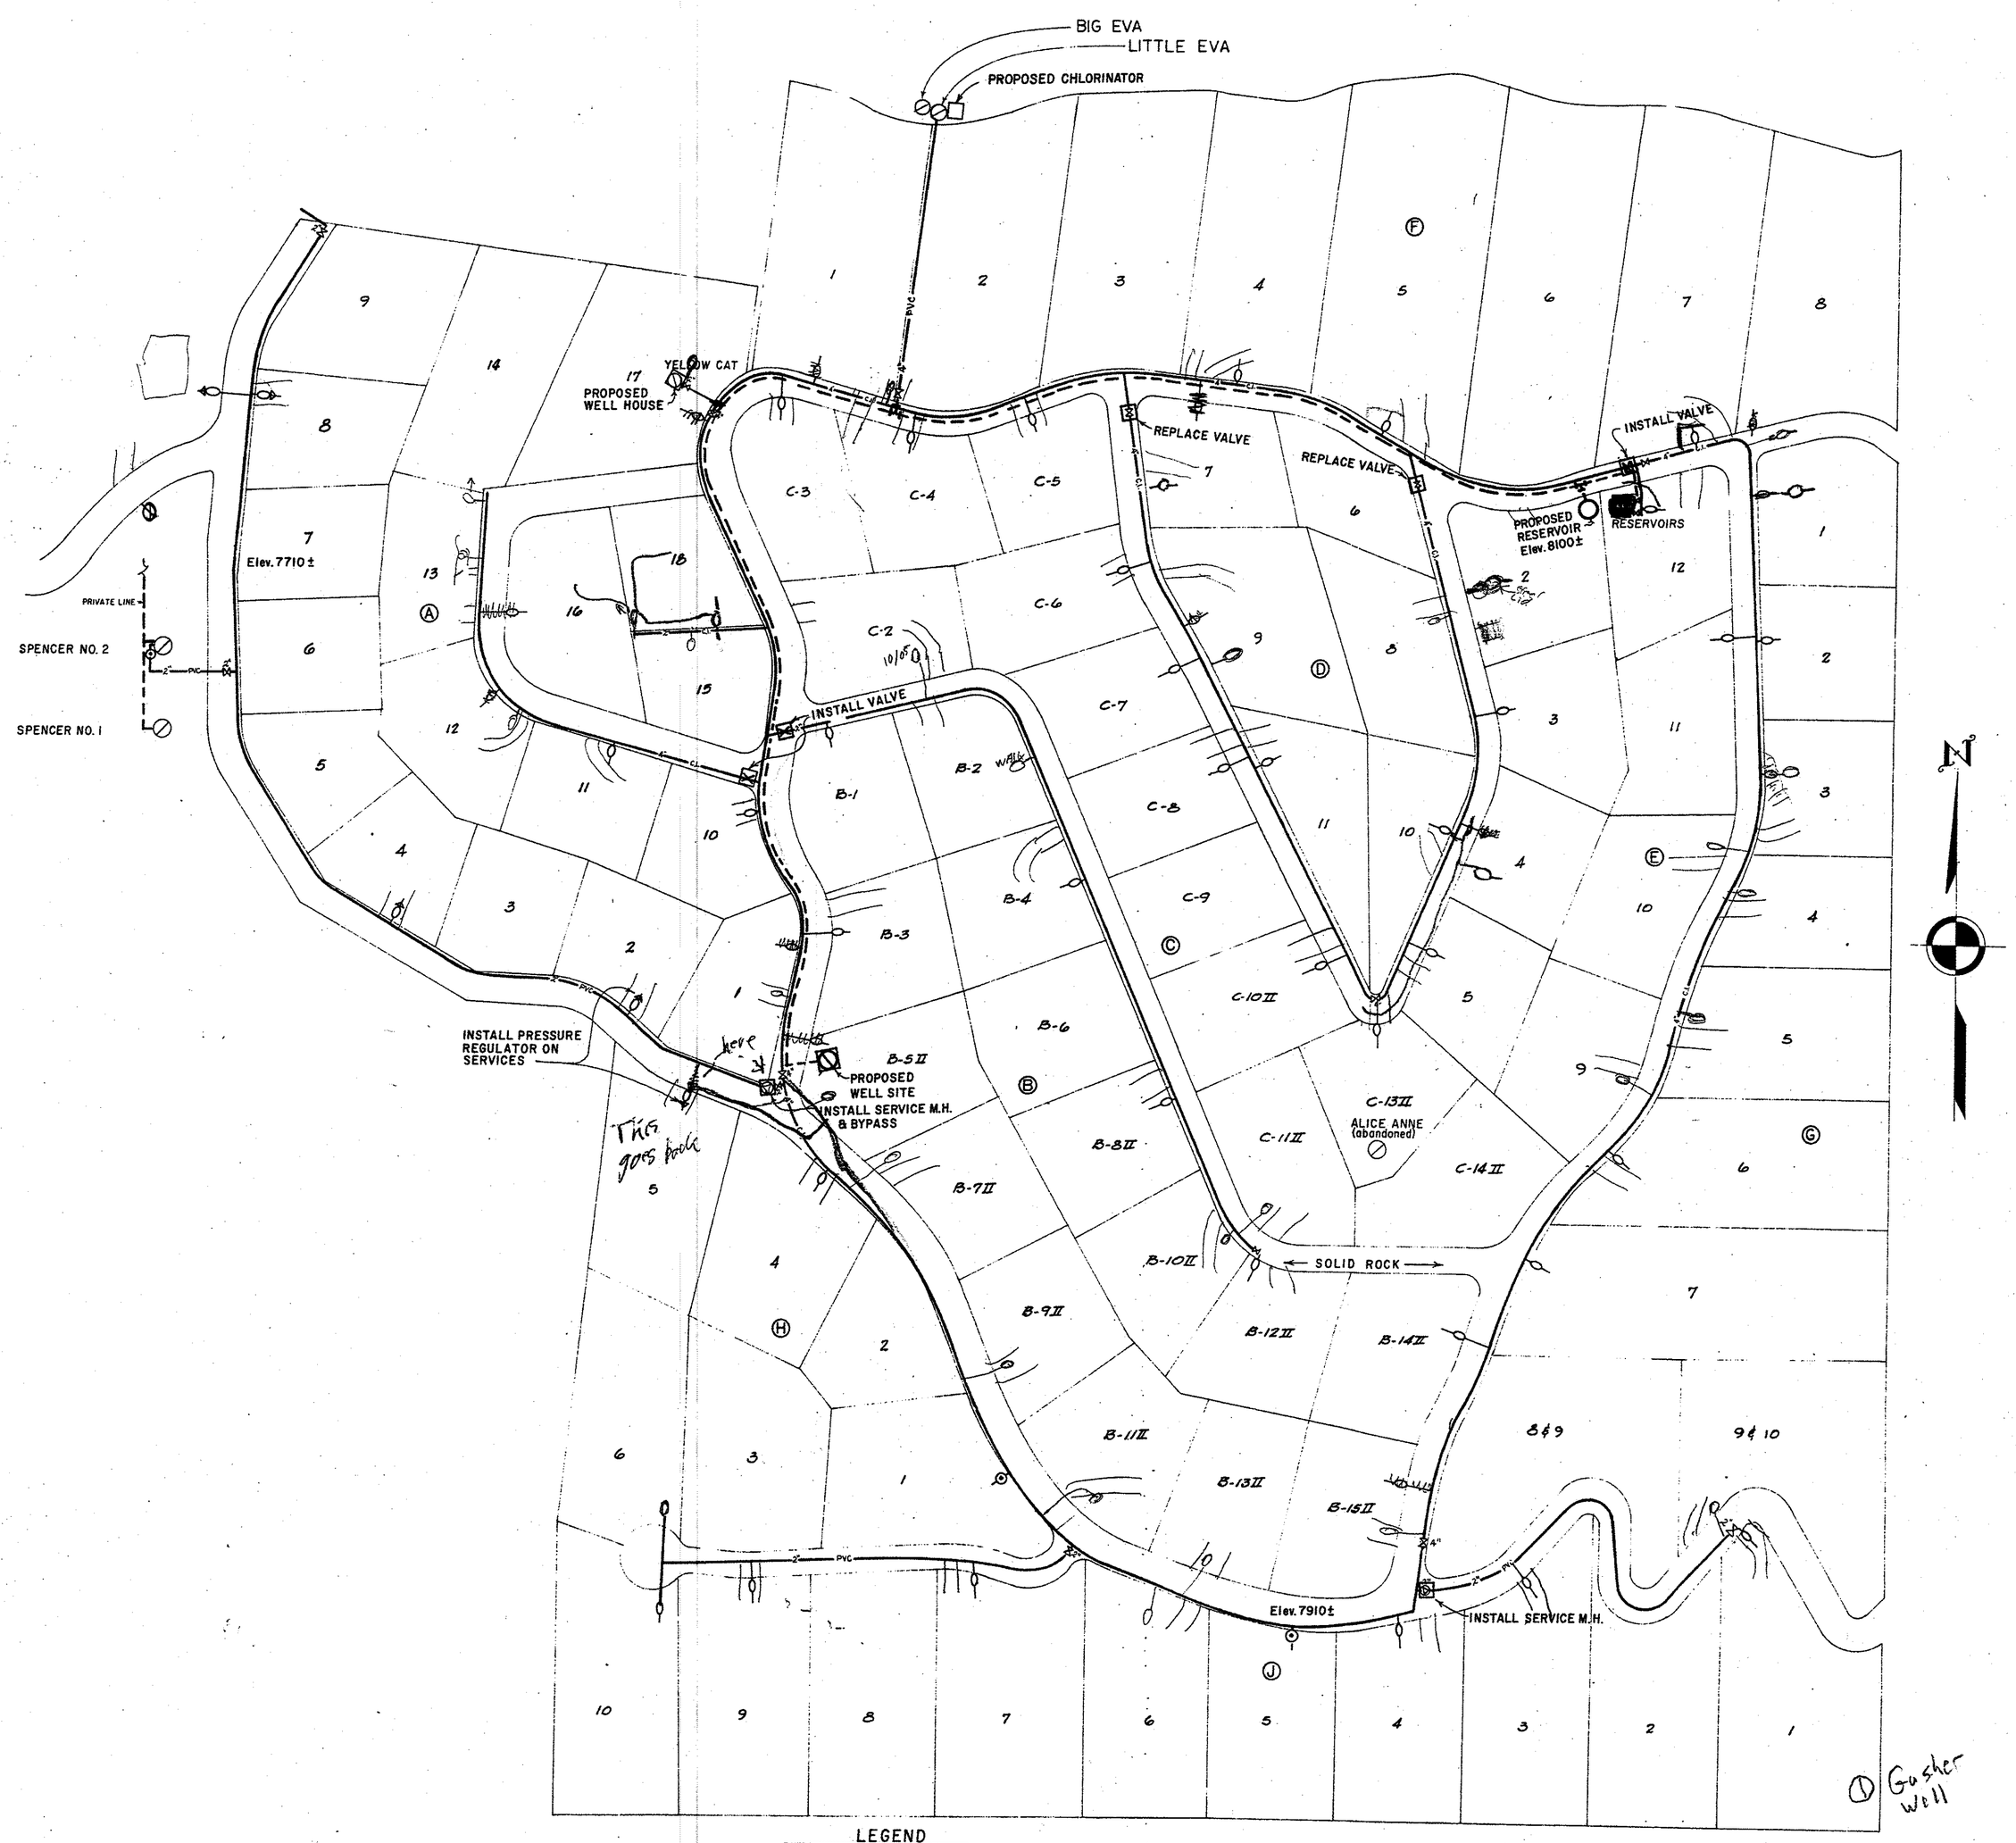

LEGEND

- WELL
- PRESSURE REGULATOR
- VALVE
- METER (Exist.)
- PROPOSED METER
- PROPOSED FACILITY

NOTE: Traced from an unmarked print of unknown origin.

HYDE PARK ESTATES WATER ASSOC.
SANTA FE, NEW MEXICO

WATER SYSTEM IMPROVEMENTS - 1984

SYSTEM MAP
PROPOSED FACILITIES

R. D. BARBER | Drawn: G.A | Scale: 1"=100'±